


MARKED UP
 PRINT
 K. WRIGHT
 5/8/03

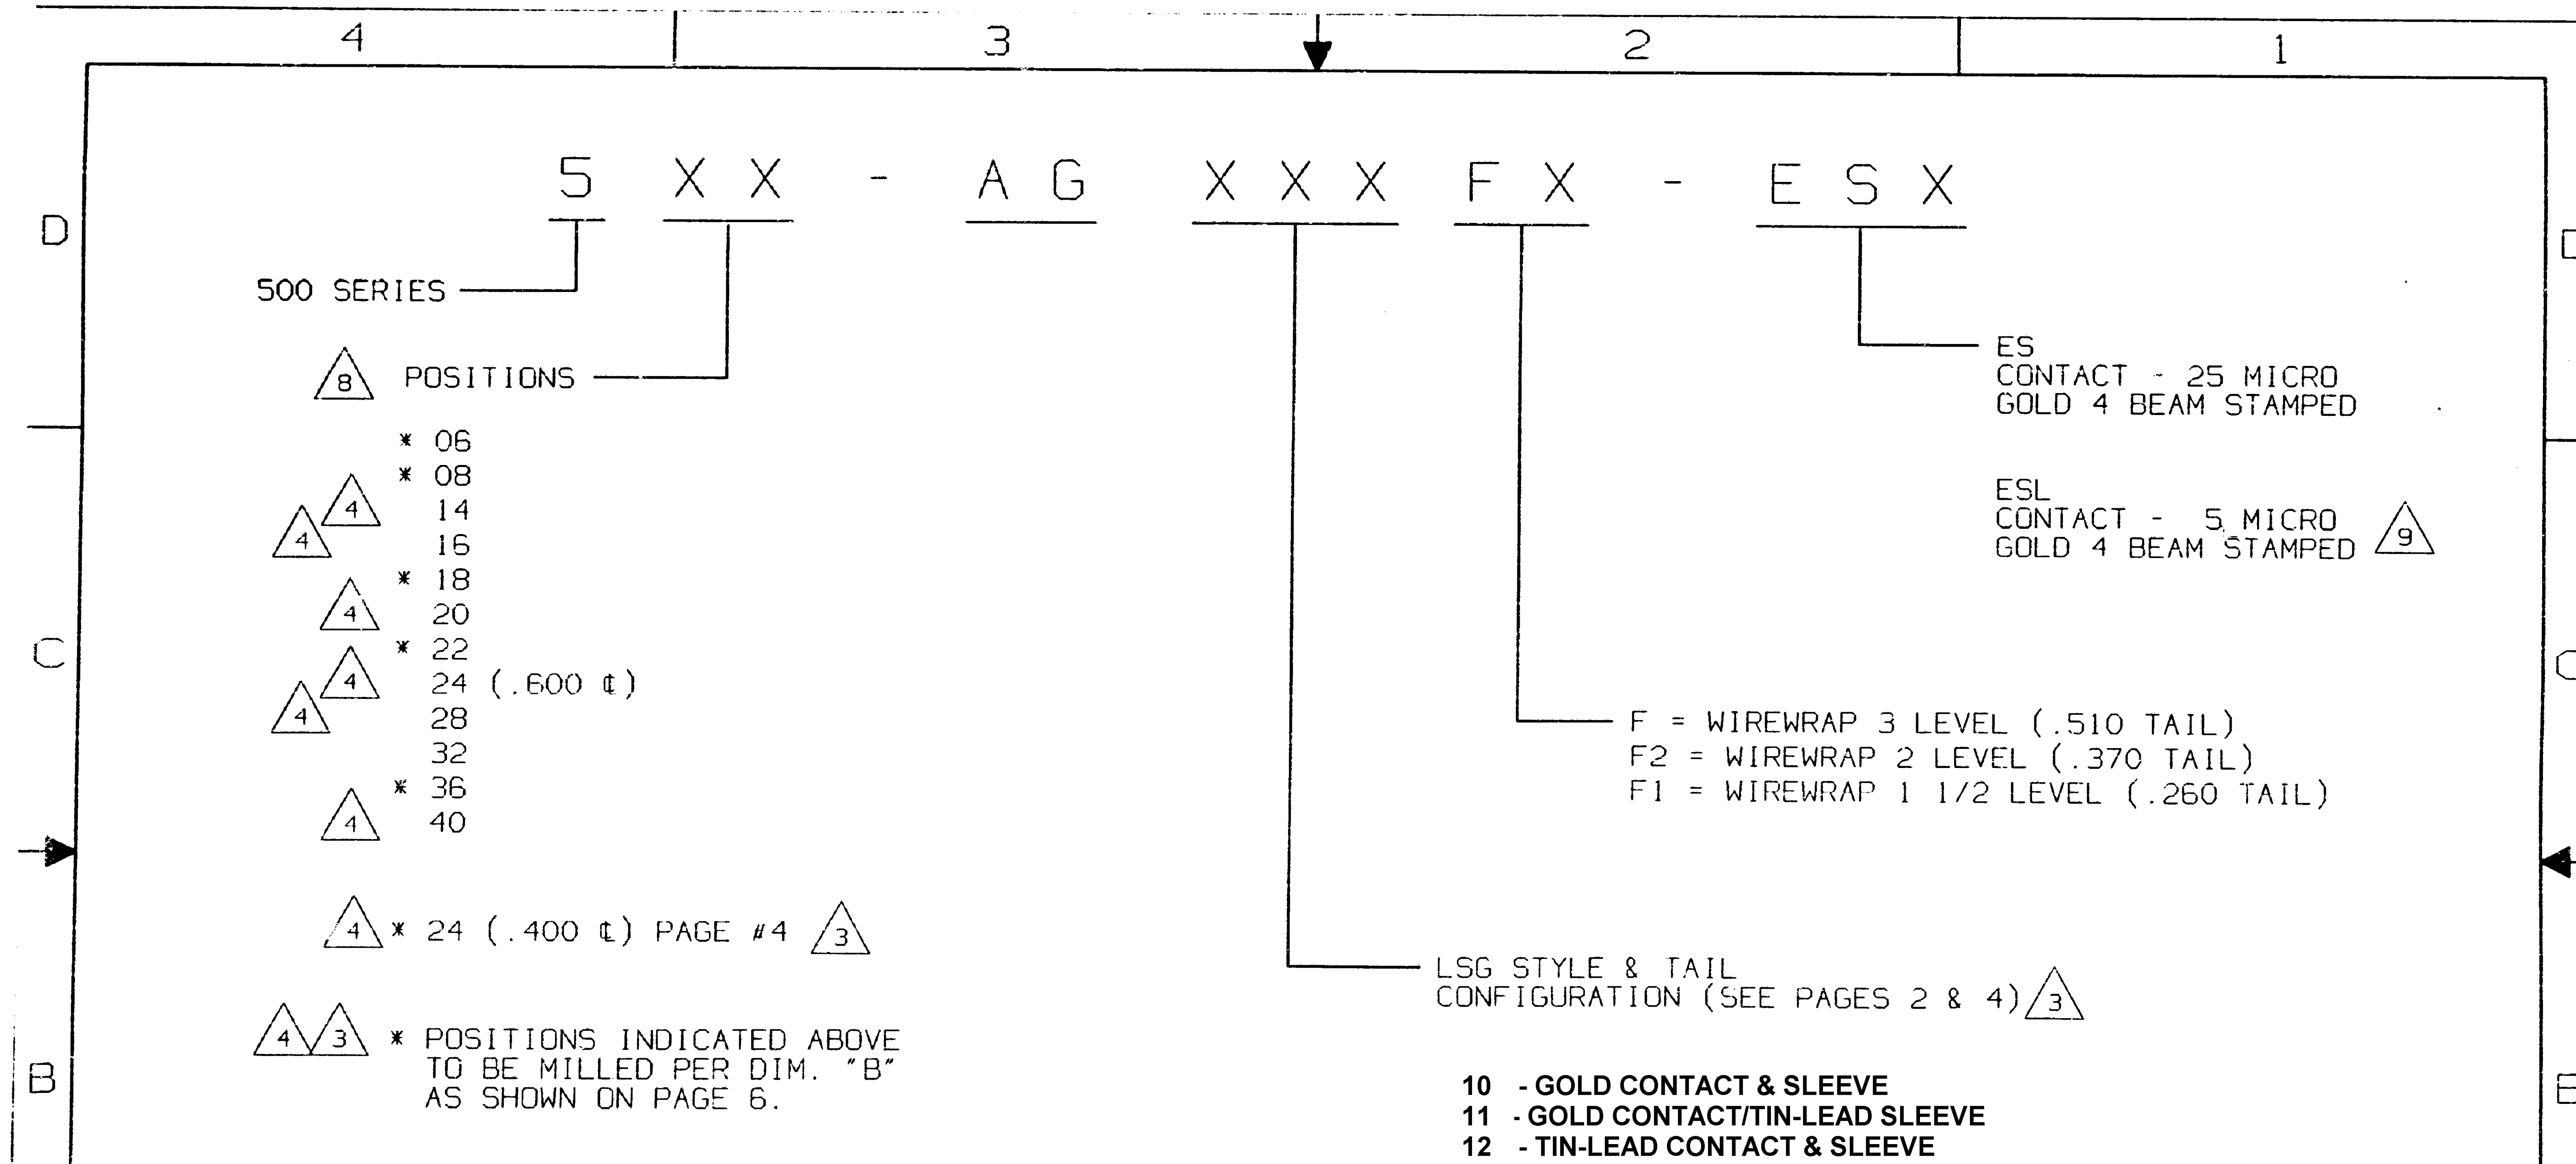


THIS IS A C.A.D. GENERATED DRAWING.
 DO NOT MAKE MANUAL REVISIONS TO MASTER.

REV	REVISIONS
1	REVISED & REDRAWN CO#C296-37 9-8-10-87 PP'D: AJC 8-27-87
2	REVISED CO#C471-87 3-11-13-87 PP'D: AJC 11-23-87
3	REVISED CO#73-90 5-2-22-90 PP'D: RES 2-25-90
4	REVISED CO#217-90 9-9-13-91 PP'D: ojc 4-2-90
5	REVISED CO#778-91 9-13-91 PP'D: RES 9-17-91
6	REVISED CO#1420-92 1-12-28-92 PP'D: CP
7	REVISED & REDRAWN CO#256-94 KIRCORIAN 9-5-95 PP'D: D.O. 9-25-95
8	REVISED CO# 744-95 S. 10-20-95 PP'D: DO'NEILL 10/24/95
9	REVISED CO# 398-96 D. 7-16-96 PP'D: O'Neill 7/16/96

UNLESS OTHERWISE SPECIFIED DIMENSIONS ARE IN INCHES DO NOT SCALE PRINT			ORIGINAL DATE OF DRAWING: 8-10-87
FILE NAME: 500AGFS	DIRECTORY: PNCODEAS	PROJECT:	DRANN: D.SANTOS DATE: 8-10-87
AUGAT CONFIDENTIAL			CHECKED: REV.6 RAY-D DATE: 12-23-92
This document contains information which is the exclusive property of Augat Inc. Distribution, reproduction or use by others is not permitted without the expressed written			APPROVED: A.CORRIDORI DATE: 8-27-87
CODE IDENT. NO. 91506	DWG. SIZE B	TITLE: ASSEMBLY SOCKET (.260, .370, .510 WW TAIL)	

AUGAT INC.		452 JOHN DIETSCH BLVD. ATTLEBORG FALLS, MASS. 02763
DWG. NO. 500-AGXXXXF-X-ES, ESL		
REV. 9		PRODUCT CODE: 156

MARKED UP
 PRINT
 K. WRIGHT
 5/8/03

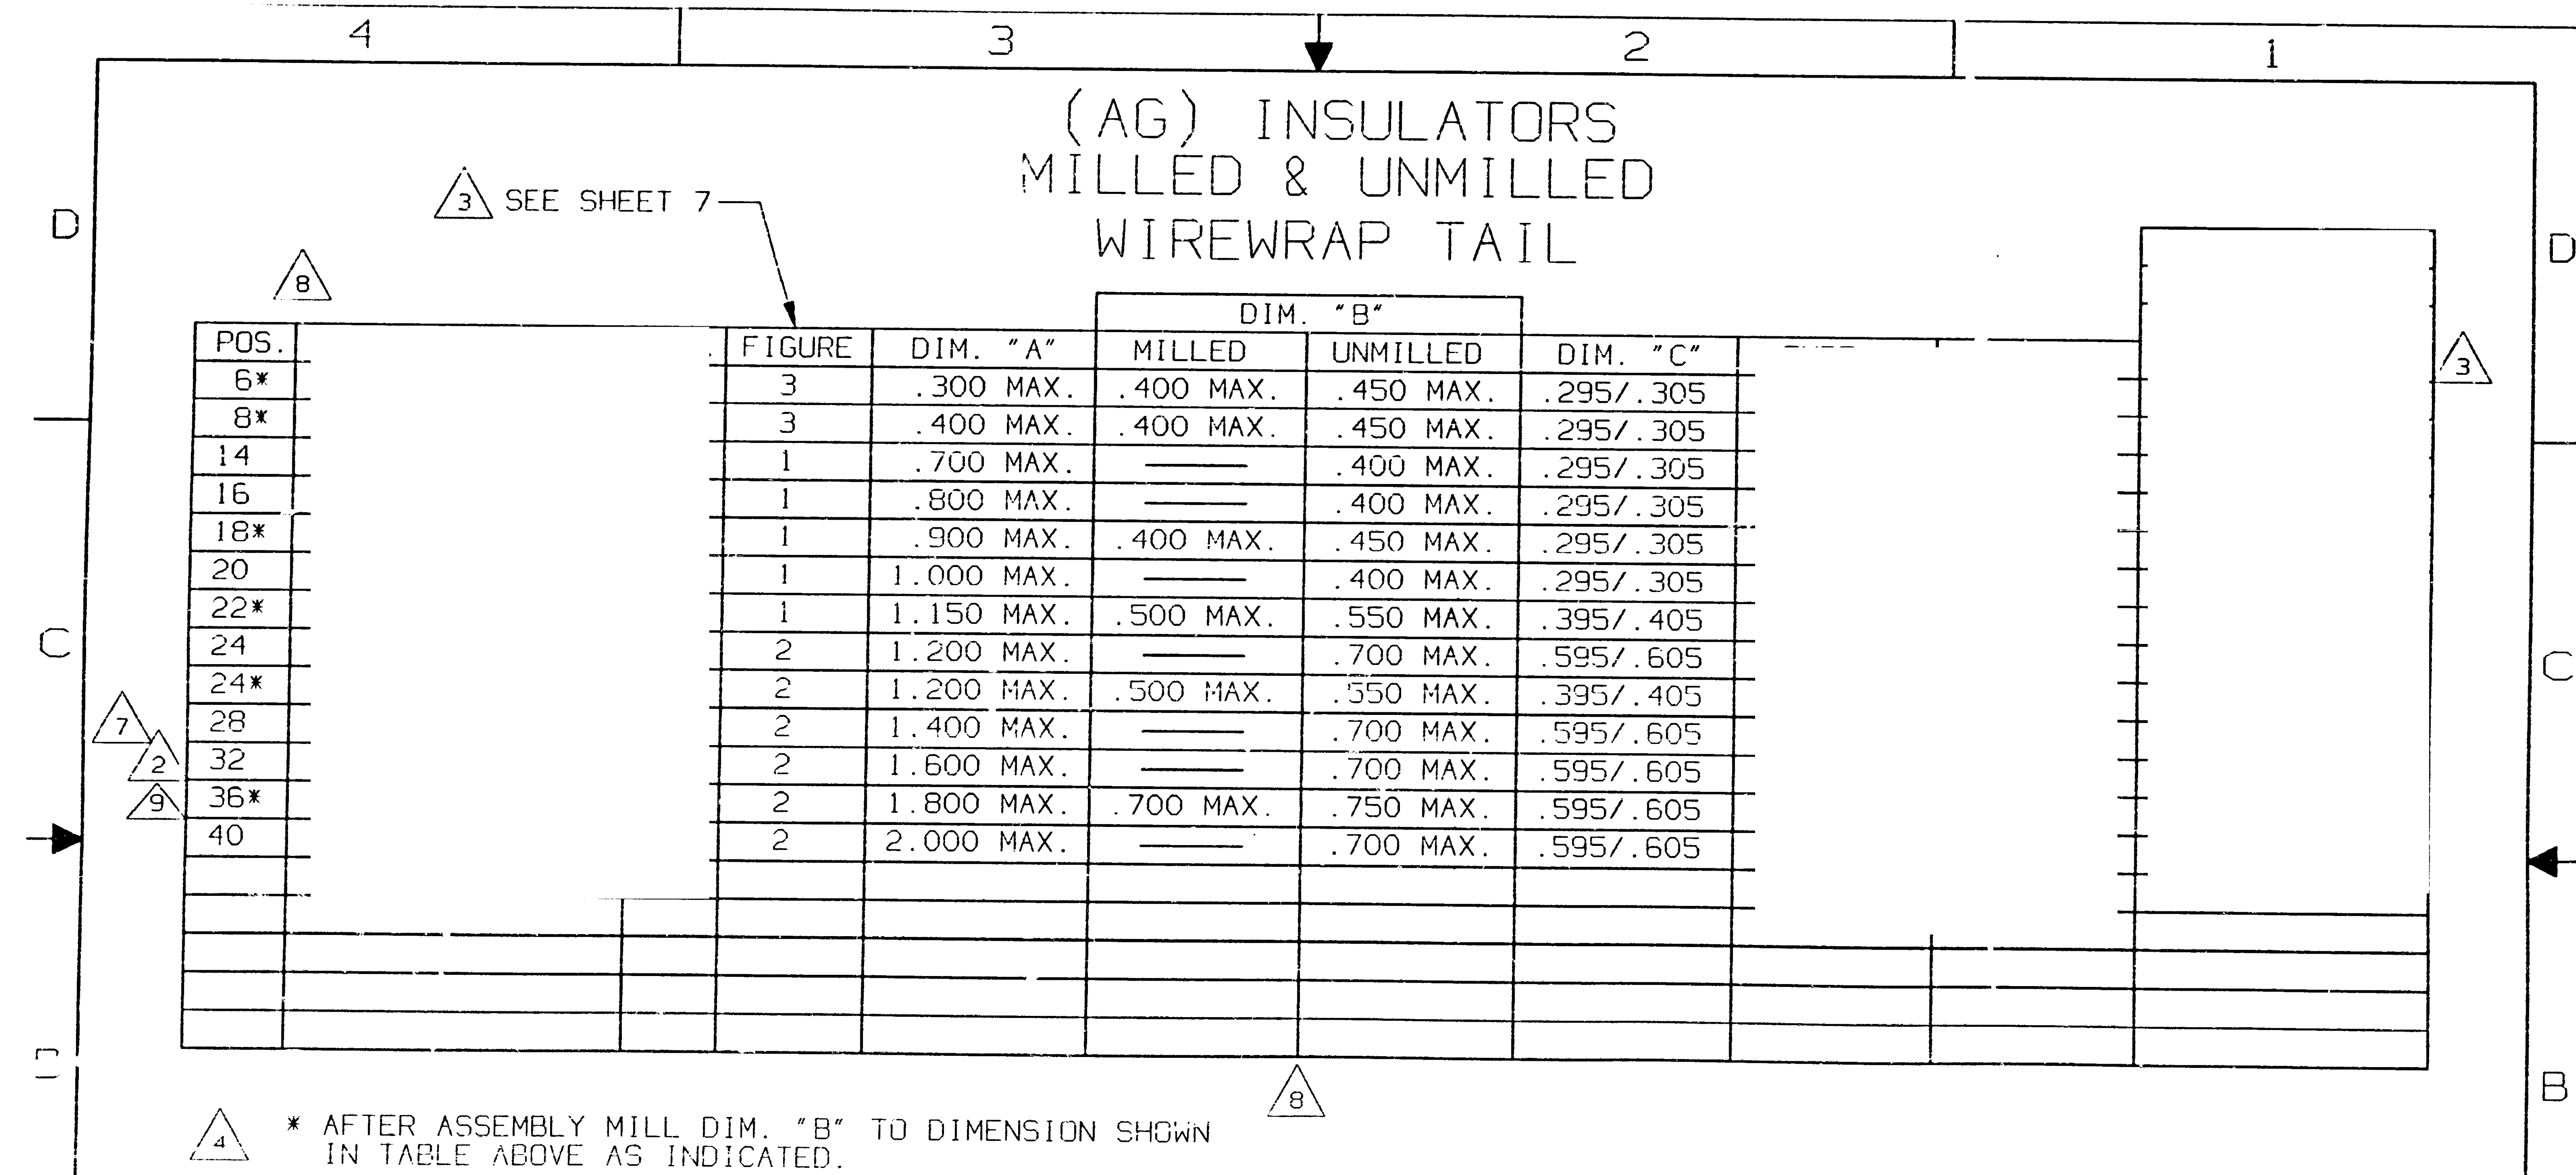

△ 4 * AFTER ASSEMBLY MILL DIM. "B" TO DIMENSION SHOWN IN TABLE ABOVE AS INDICATED.

THIS IS A C.A.D. GENERATED DRAWING.
 DO NOT MAKE MANUAL REVISIONS TO MASTER.

REV	SEE SHEET 1
REVISIONS	

UNLESS OTHERWISE SPECIFIED
 DIMENSIONS ARE IN INCHES
 DO NOT SCALE PRINT

FILE NAME: 500AGF56
 DIRECTORY: PNC00EAS
 PROJECT:

AUGAT CONFIDENTIAL

This document contains information which is the exclusive property of Augat Inc. Distribution, reproduction or use by others is not permitted without the expressed written consent of Augat Inc.

ORIGINAL DATE OF DRAWING: 8-10-87

DRAWN: D. SANTOS
 DATE: 8-10-87

CHECKED: REV. 6 RAY-D
 DATE: 12-29-92

APPROVED: A. CORRIGOR
 DATE: 8-27-87

CODE IDENT. NO. 91506
 DWG. SIZE B


AUGAT INC.
 452 JOHN DIETSCH BLVD.
 ATTLEBORO FALLS, MASS. 02763

TITLE: ASSEMBLY SOCKET
 (.260, .370, .510 WW TAIL)

DWG. NO. 500-AGXXXFX-ES, ESL
 REV. 9

PRODUCT CODE: 156

MARKED UP
PRINT
K. WRIGHT
5/8/03

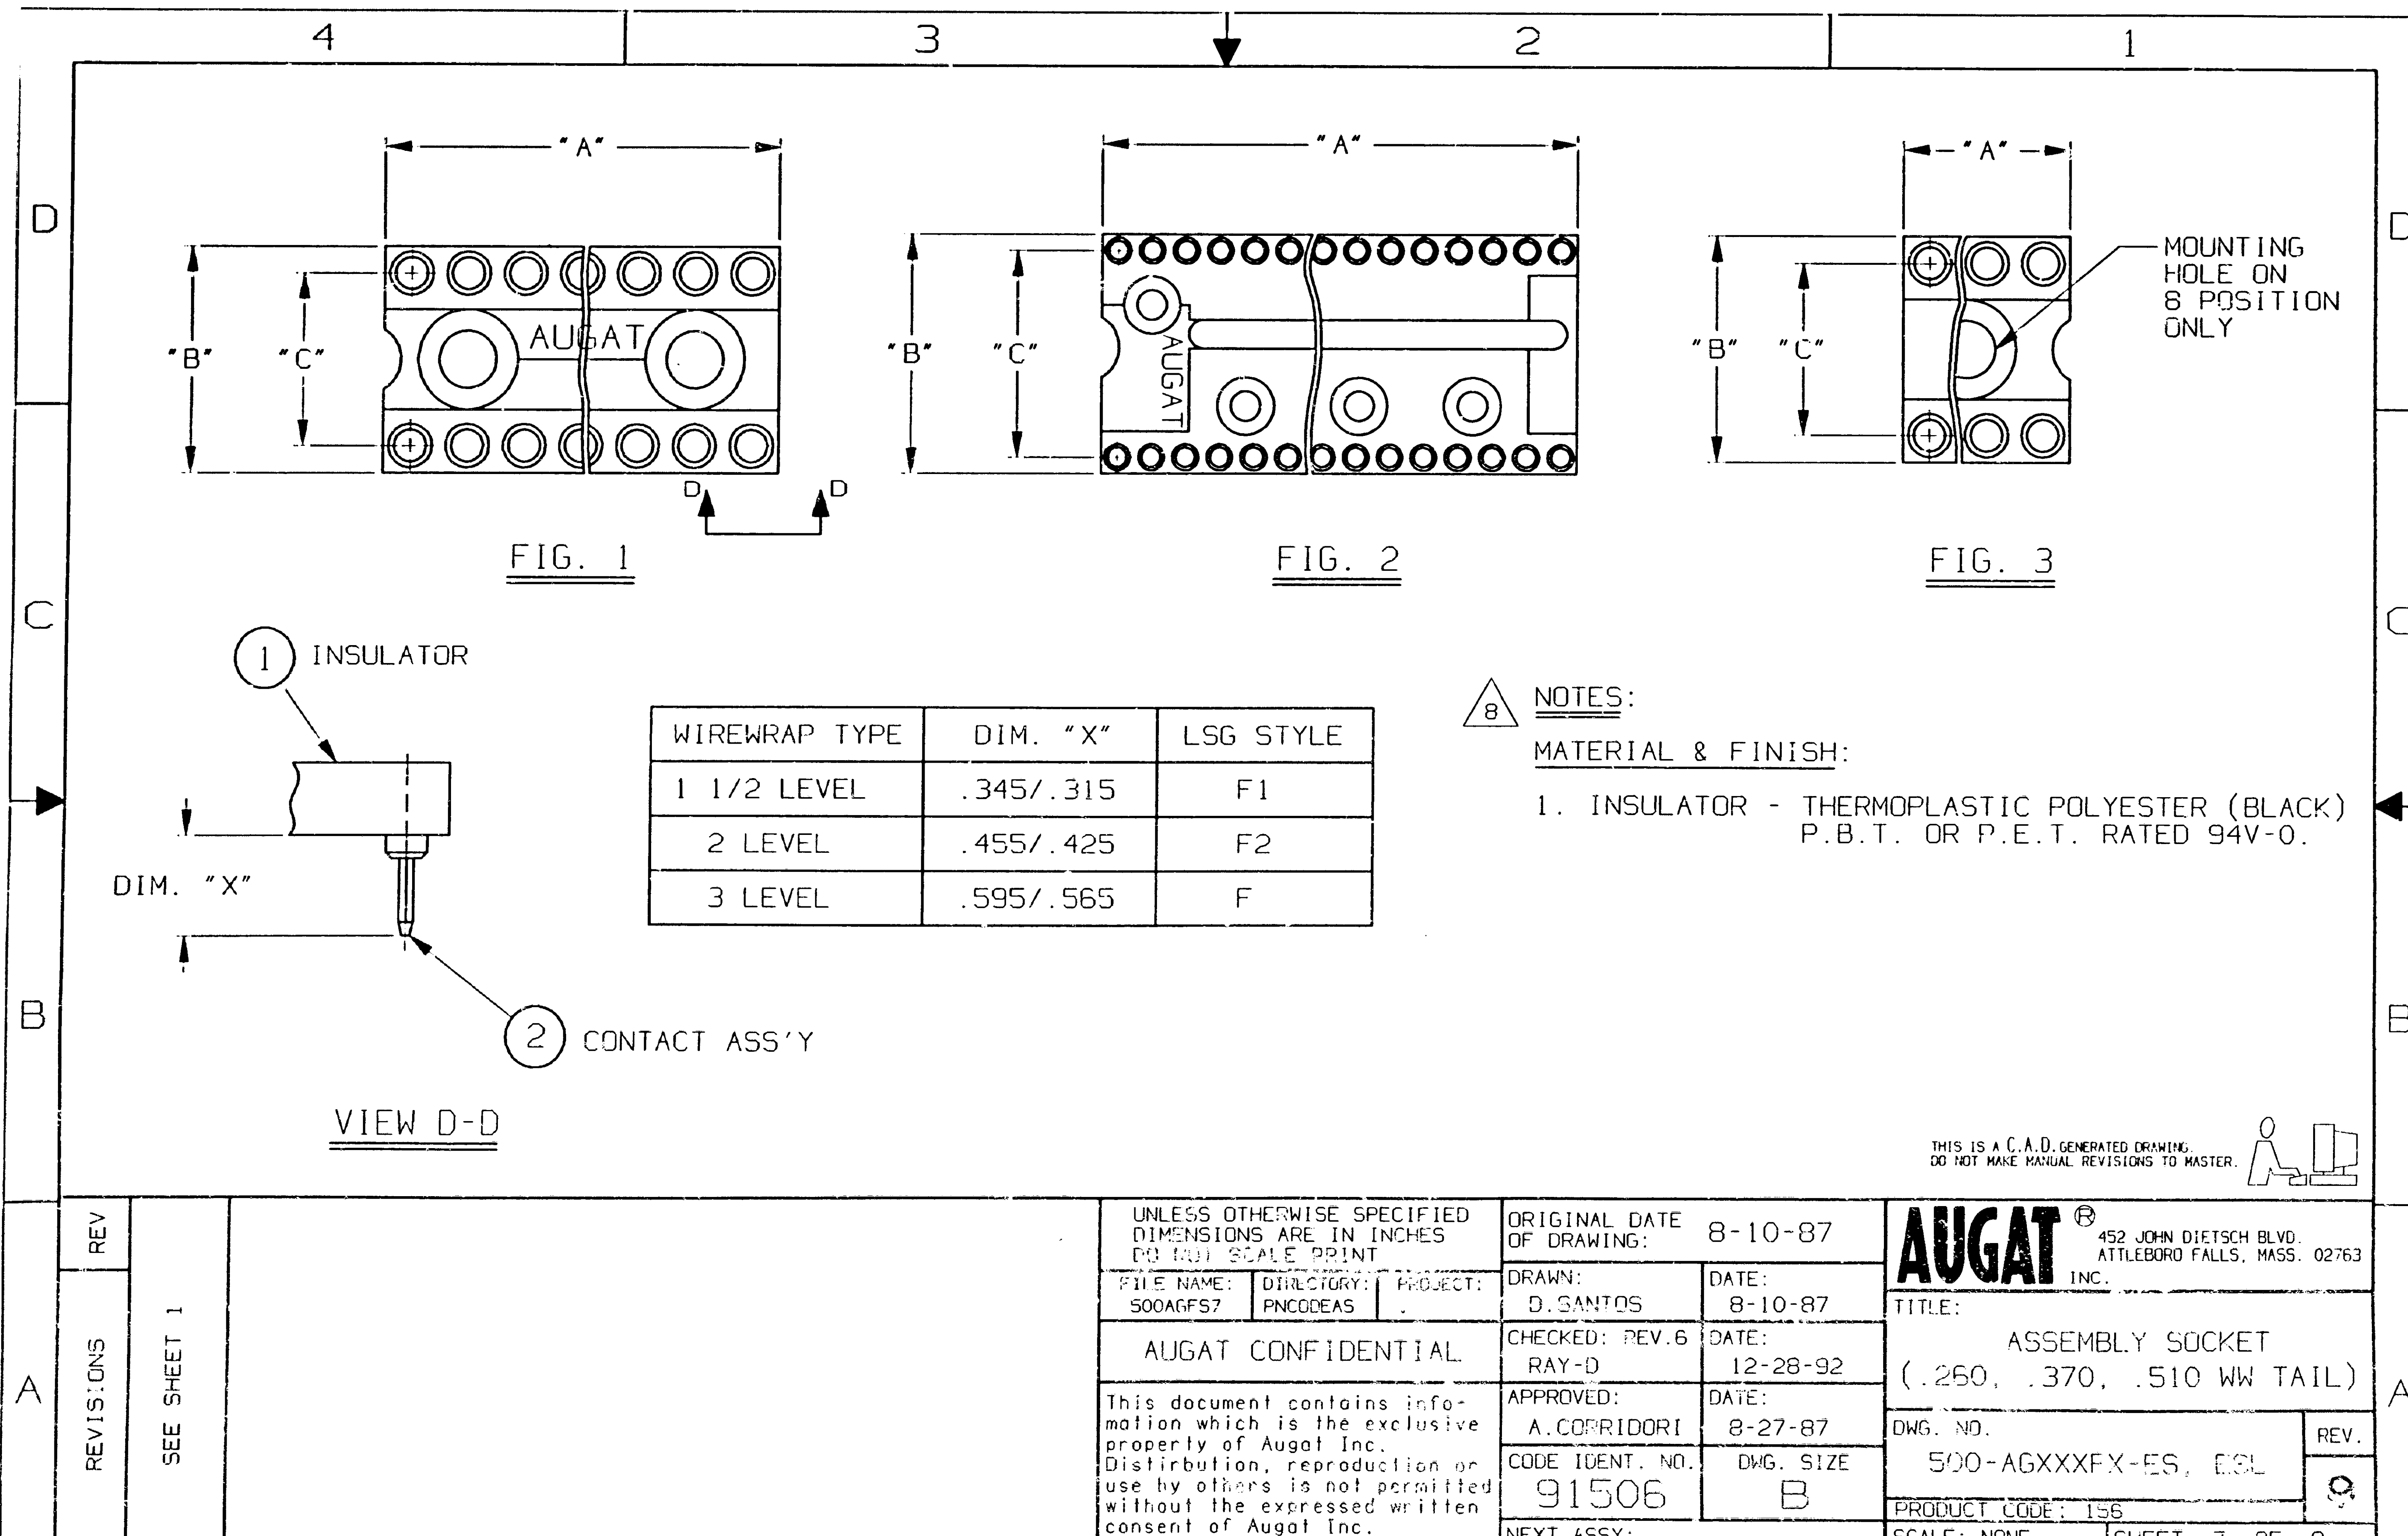

A	REV	
	REVISIONS	SEE SHEET 1

UNLESS OTHERWISE SPECIFIED DIMENSIONS ARE IN INCHES TO NEAREST SCALE PRINT			ORIGINAL DATE OF DRAWING: 8-10-87		AUGAT 452 JOHN DIETSCH BLVD. ATTLEBORO FALLS, MASS. 02763 INC.
FILE NAME: 500AGFS7	DIRECTORY: PNCODEAS	PROJECT:	DRAWN: D. SANTOS	DATE: 8-10-87	
AUGAT CONFIDENTIAL			CHECKED: REV. 6 RAY-D	DATE: 12-28-92	TITLE: ASSEMBLY SOCKET (.250, .370, .510 WW TAIL)
This document contains information which is the exclusive property of Augat Inc. Distribution, reproduction or use by others is not permitted without the expressed written consent of Augat Inc.			APPROVED: A. CORRADORI	DATE: 8-27-87	DWG. NO. 500-AGXXXX-ES, E3L
			CODE IDENT. NO. 91506	DWG. SIZE B	REV. 1
NEXT ASSY:			PRODUCT CODE: 156		SCALE: NONE